


193

NTPC ELECTRIC SUPPLY COMPANY LTD.
AS BUILT DRAWING
 NAME OF THE MOUZA : KRISHNAGERIA
 CENSUS CODE : 03259700
 JL. NO : 431

RURAL ELECTRIFICATION WORKS UNDER RGGVY SCHEME FOR KHARAGPUR, DISTRICT OF PASCHIM MEDINAPUR
 NAME OF THE PARAVTOLA : MAIN VILLAGE
 NAME OF THE GP : CHAKMAUSAMPUR
 NAME OF THE BLOCK : KGP-II

RAJIV GANDHI GRAMEEN VIDYUTIKARAN YOJANA(RGGVY)
 Vijai Electricals Ltd.
 Project Division
 Boudhiguda, Hyderabad-42

DRAWING SHEET NO : 1
 NAME OF THE 11KV FEEDER : BELDA-II
 NAME OF THE 33KV S/S : GOPALI

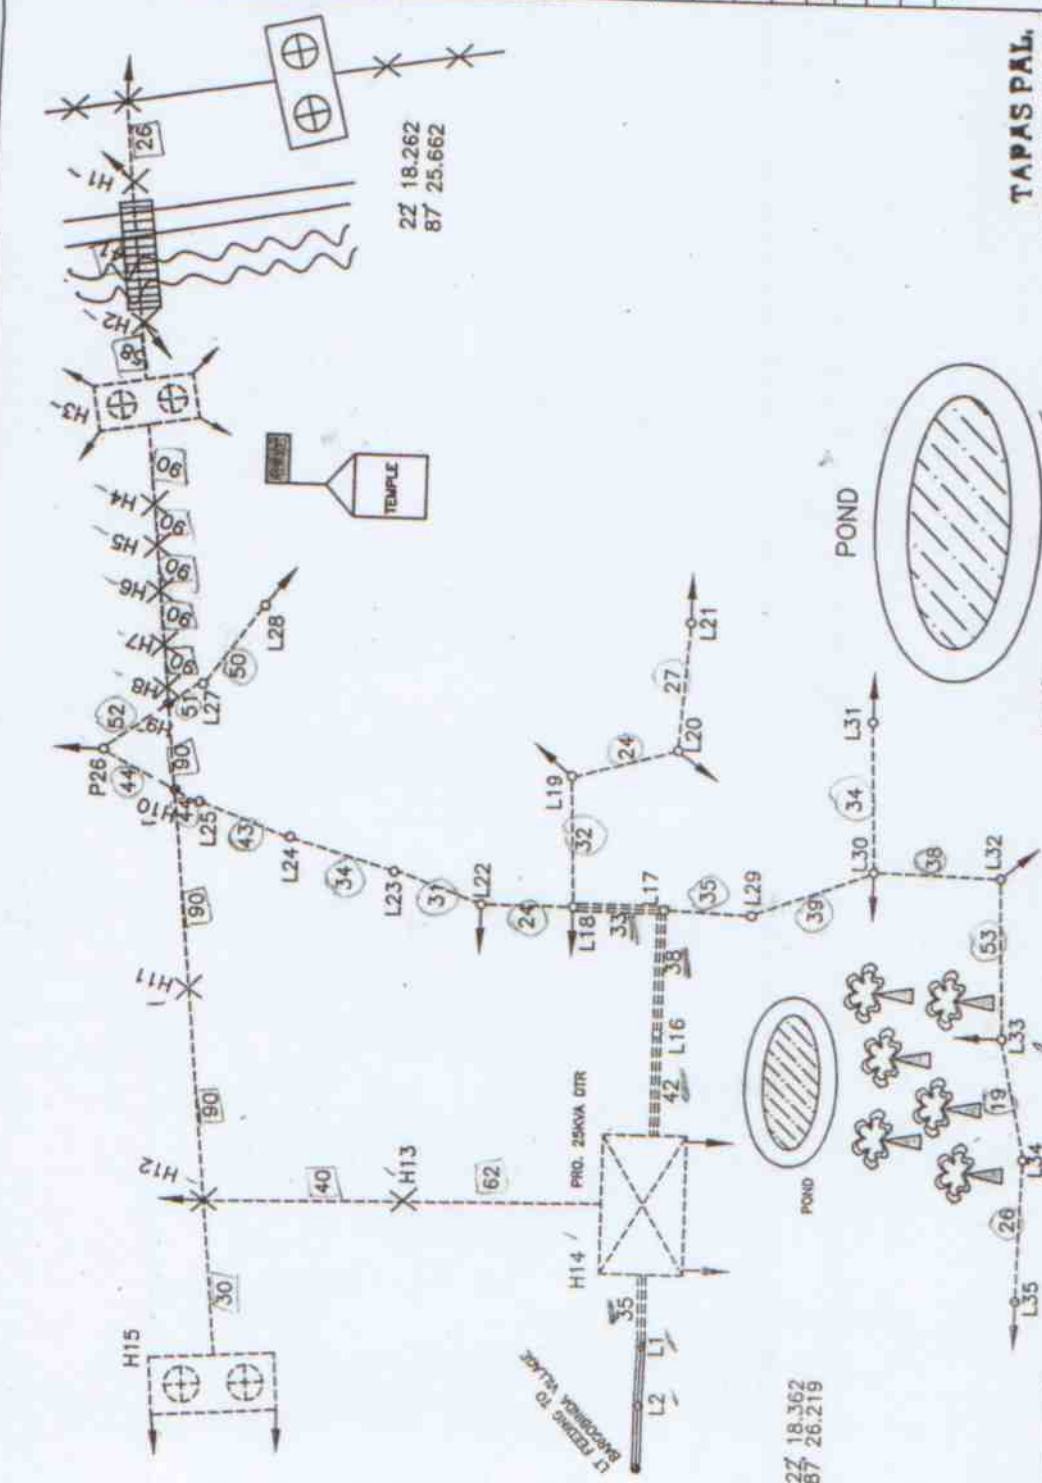

NO. OF BPL CONSUMERS		14
TOTAL NO. OF PUBLIC UTILITIES		
NO. OF SCHOOLS		
NO. OF HLTH. CENTERS		
PANCHAYAT HOUSE:		
HT SINGLE POLES	NOS.	10
HT DTRs	NOS.	02
DTR-POLES	NOS.	02
LT POLES	NOS.	(21)
HT STAY	NOS.	13
LT STAY	NOS.	11
HT SPIKE EARTHING	NOS.	10
HT PIPE EARTHING	NOS.	07
LT SPIKE EARTHING	NOS.	21
10KVA DTR	NOS.	-
15KVA DTR	NOS.	-
25KVA DTR	NOS.	01
CRADLE GUARDING	RM	01
SKY GAUARDING	RM	-
ACSR (WEASEL)	CM KM	1087
HT ABC	CM KM	-
1-PH. LT ABC	CM KM	700
3-PH. LT ABC	CM KM	148
NAME & SIGN. OF LICENSE SUP.		

TAPAS PAL,
 DEPUTY MANAGER
 NTPC Electric Supply Co. Ltd.
 West Bengal
 Kharagpur
 NESCO, KHARAGPUR

INDO JYOTI 'regentary' Belora
 Chaitanya Khari
 SR. PROJECT MANAGER, VEL, KGP
 NTPC Electric Supply Co. Ltd.
 Kharagpur

CONSTR. MGR. VEL, KGP
 SIGN OF SUP/ENGR. VEL, KGP
 27 18.362
 87 26.219

DRAWN BY: S.S. HALDAR
 CHECKED BY:

AS PER SURVEY


Sheet no-1

NTPC ELECTRIC SUPPLY COMPANY LTD.
ENGINEERING DEPARTMENT
withhoda
BLOCK NAME : KGR. 2
NEAR CITY :

RAJIV GANDHI GRAMEEN VIDYUTIKARAN YOJANA(RGGVY)
RURAL ELECTRIFICATION WORKS UNDER RGGVY SCHEME FOR KHARAGPUR DISTRICT OF PASCHIM MEDINIPUR
CENSUS CODE : 5712900
REF NO. : 554
GRID SS : Debraj
DIST FROM GRID SS :

Vijai Electricals Ltd.
Dist. FROM AAD VILLAGE(WAHE)
EXECUTION: BOBCAT/MANU

RESIDENTIAL CONSUMERS	102
NO. OF BFL CONSUMERS	31
NO. OF APL Physically found	54
NO. OF INDUSTRIAL CONSUMERS	Public Institution
TOTAL NO. OF PUBLIC UTILITIES	02
NO. OF SCHOOLS	01
NO. OF HEALTH CENTERS	-
NO. OF COMMUNITY CENTERS	-
PANCHAYAT HOUSE:	-
ANY OTHER SPECIFY	-
ANY EXT DTR AND RATING	63KV IN U
TOTAL HT	35
TOTAL LT 1-PHASE	926
TOTAL LT 3-PHASE	21 U
DTR 10KVA (ON LINE)	-
DTR 10KVA (DEAD END)	01
DTR 10KVA IN LINE	-
DTR 10KVA DEAD END	-
DTR 25KVA (DEAD END)	-
EXISTING DTR	63KV IN U
DP (IN LINE ANGULAR/DEAD END)	0
CRADOLE GUARDING	3000
STAY SET	-
TAP POINT	-
EXISTING 1PH LT LINE	-
EXISTING 2PH LT LINE	-
EXISTING 3PH LT LINE	-
LT (60-90)	-
DRAWN BY :	
CHECKED BY :	

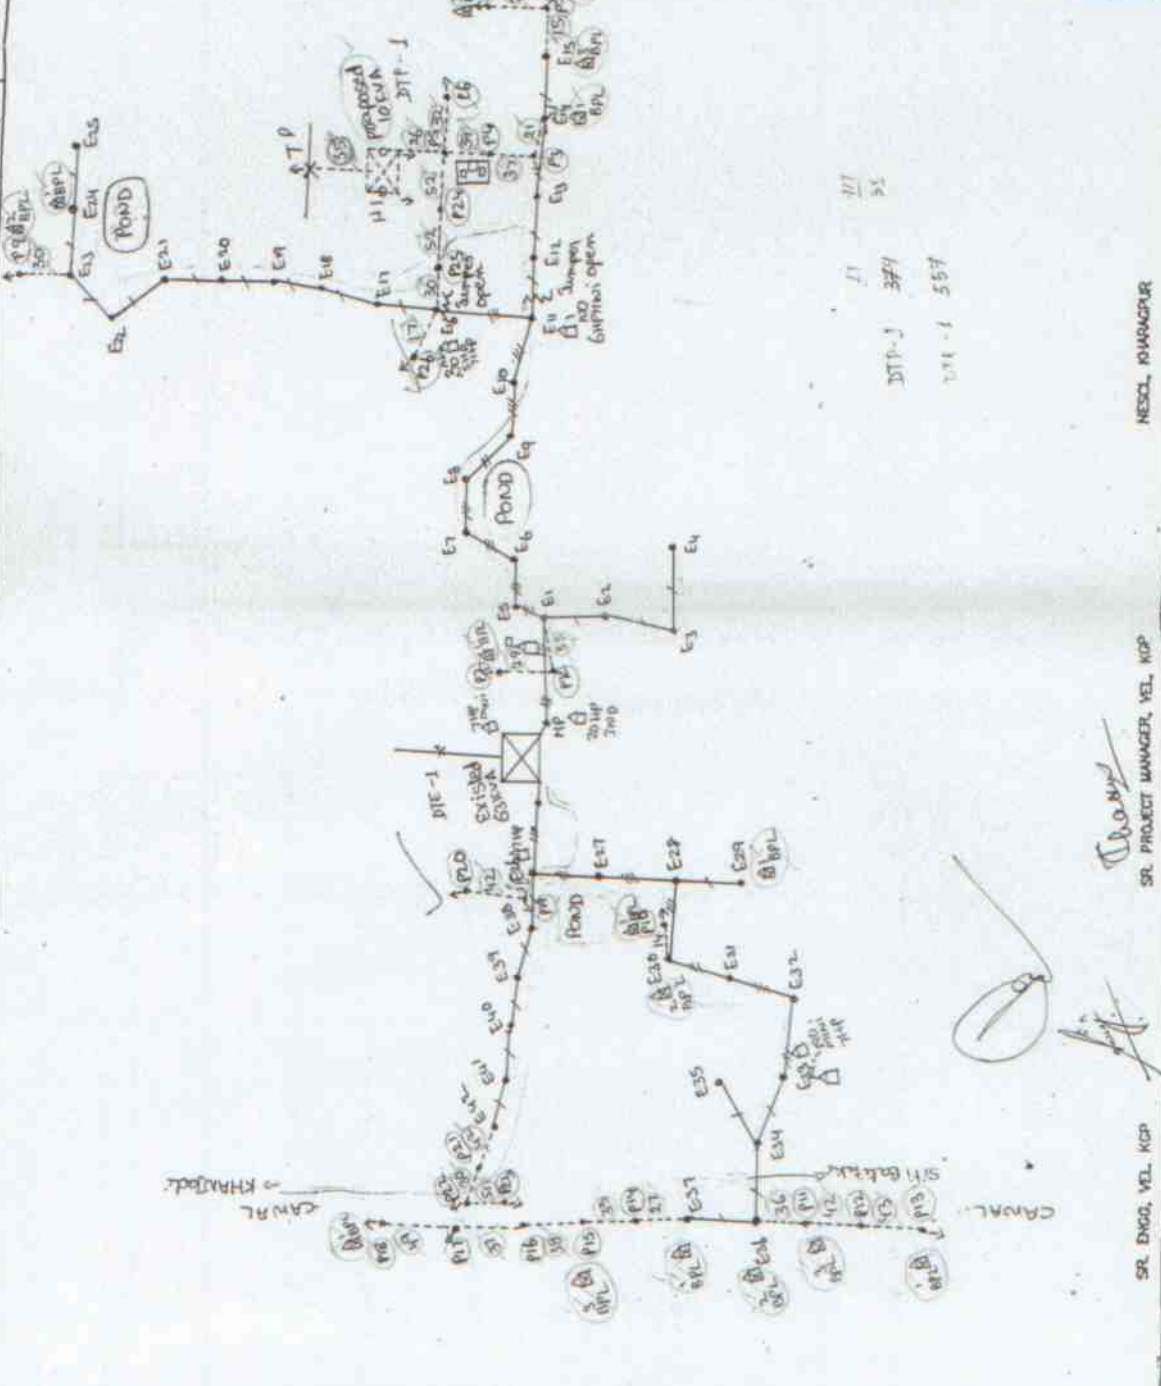

SR. ENGRG. VEL. KCP
SR. PROJECT MANAGER, VEL. KCP
SR. SCHOOL WEL. VEL. KCP
SR. PANCHAYAT BIKRAM
SR. RIVER/MALA/CANAL
SR. HILL
SR. WOOD
SR. TEMPLE
SR. HAND PUMP
SR. BFL HOUSE
SR. EXISTING DTR
SR. ROAD
SR. POND
SR. BRIDGE

NOTE:
1. ALL LENGTHS ARE IN METERS.
2. STAY SET AS PER ARRANGEMENT.

08